






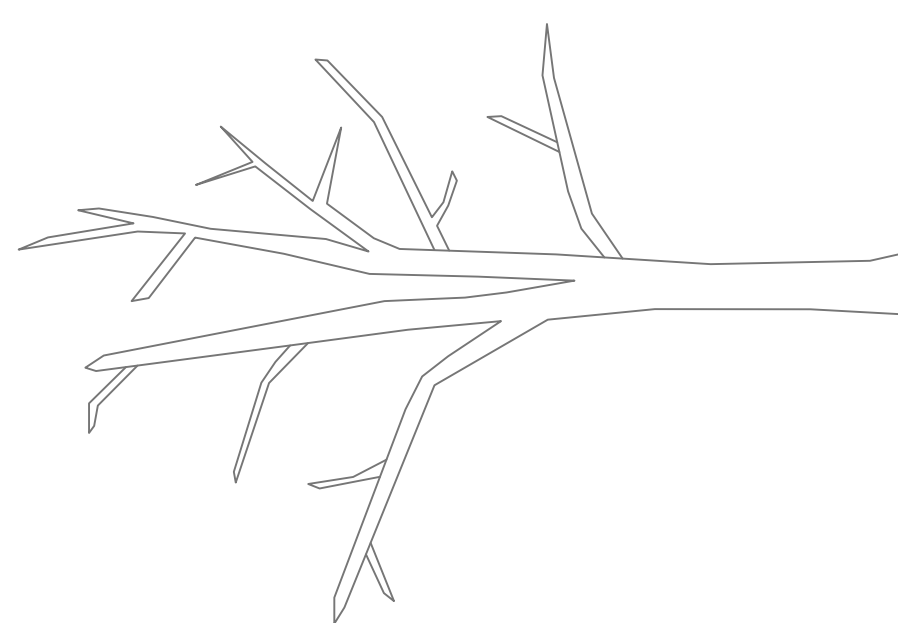


LEGEND

-  AS-BUILT HABITAT LOG
-  ARMOR STONE DESIGN
-  SHOAL CENTERLINE
-  ARMOR STONE AS-BUILT
-  AS-BUILT GRADE
-  AS-BUILT ARMOR STONE
-  AS-BUILT TOPSOIL
-  AS-BUILT 1X3 STONE

PROJECT NUMBER:	52462
DATE:	05/13/22
SCALE:	1"=20'
DESIGNED BY:	
DRAWN BY:	JAB
CHECKED BY:	
APPROVED BY:	

REVISIONS
06/07/2022

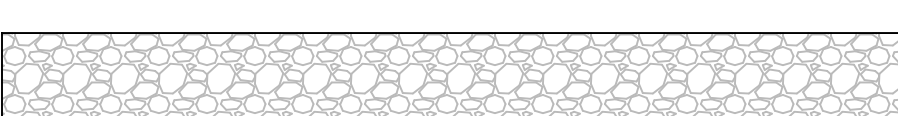ENGINEERING FOR RESULTS
 13500 REECK ROAD
 SOUTHGATE, MI 48195
 (734) 759-1600
 FAX (734) 282-6566
 WWW.ENGINEERS.COM




HENNESSEY ENGINEERS, INC.

TITLE
 SHOAL S-A ARMOR STONE AS-BUILTS
 SOUTH HENNEPIN MARSH
 THE DETROIT RIVER
 WAYNE COUNTY, MICHIGAN

SHEET
 AB N2

PROJECT NUMBER:
52462
DATE:
05/13/22
SCALE:
1"=30'
DESIGNED BY:
DRAWN BY:
JAB
CHECKED BY:
APPROVED BY:

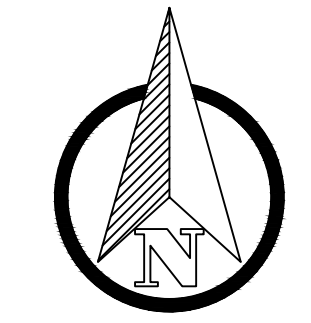


REVISIONS
06/07/2022

ENGINEERING FOR RESULTS
13500 REECK ROAD
SOUTHGATE, MI 48195
(734) 759-1600
FAX (734) 282-6566
WWW.HENNESSEY-ENGINEERS.COM



TITLE
SHOAL S-B CORE STONE AS-BUILTS
SOUTH HENNEPIN MARSH
THE DETROIT RIVER
WAYNE COUNTY, MICHIGAN

SHEET
AB S1

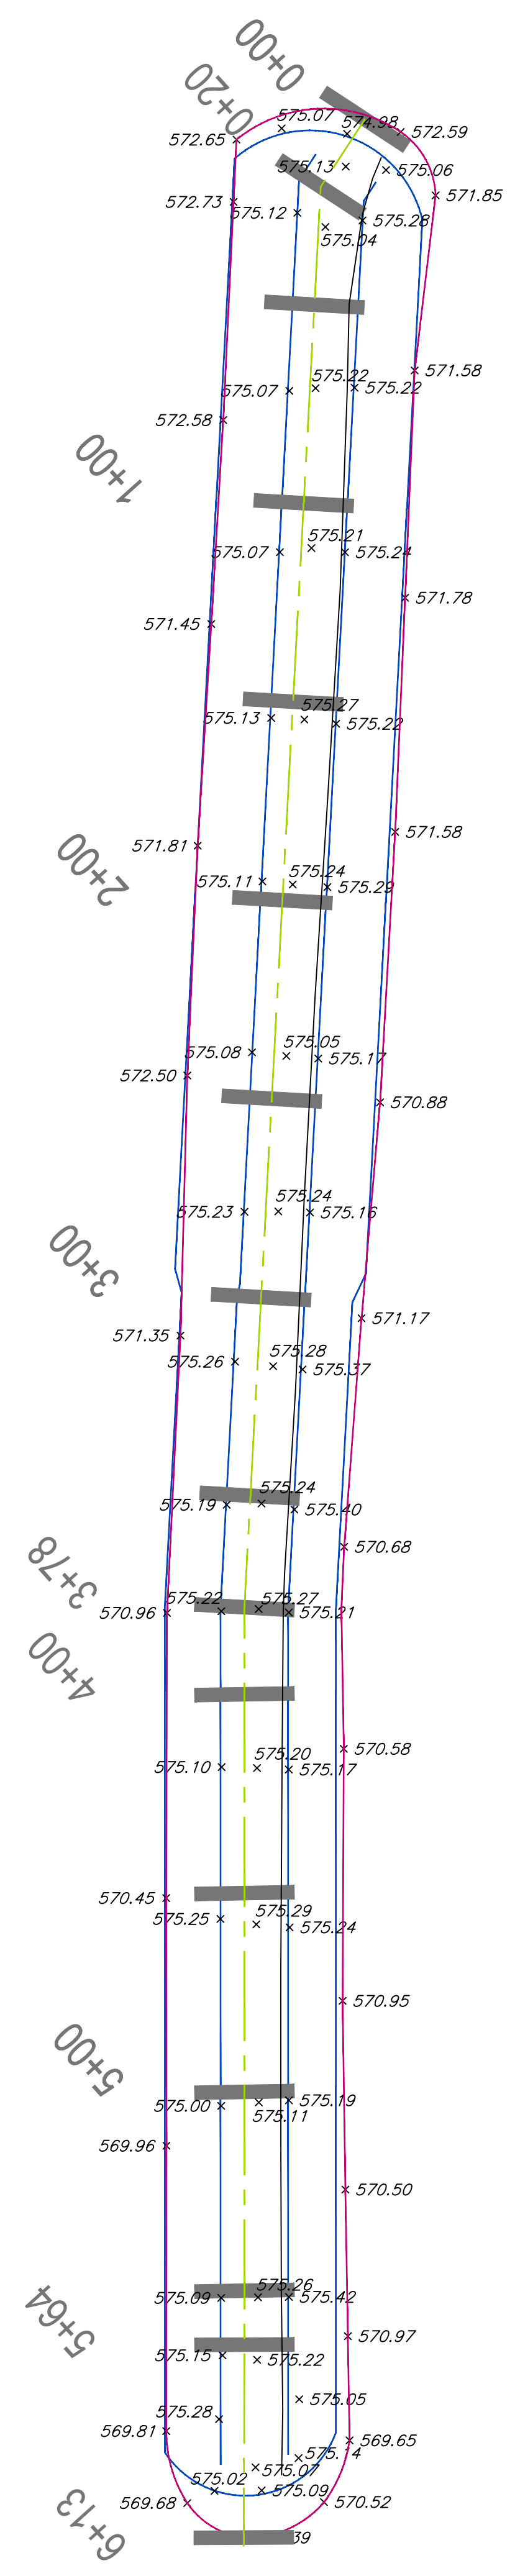

LEGEND

- CORE STONE DESIGN
- SHOAL CENTERLINE
- CORE STONE AS-BUILT
- AS-BUILT GRADE

